


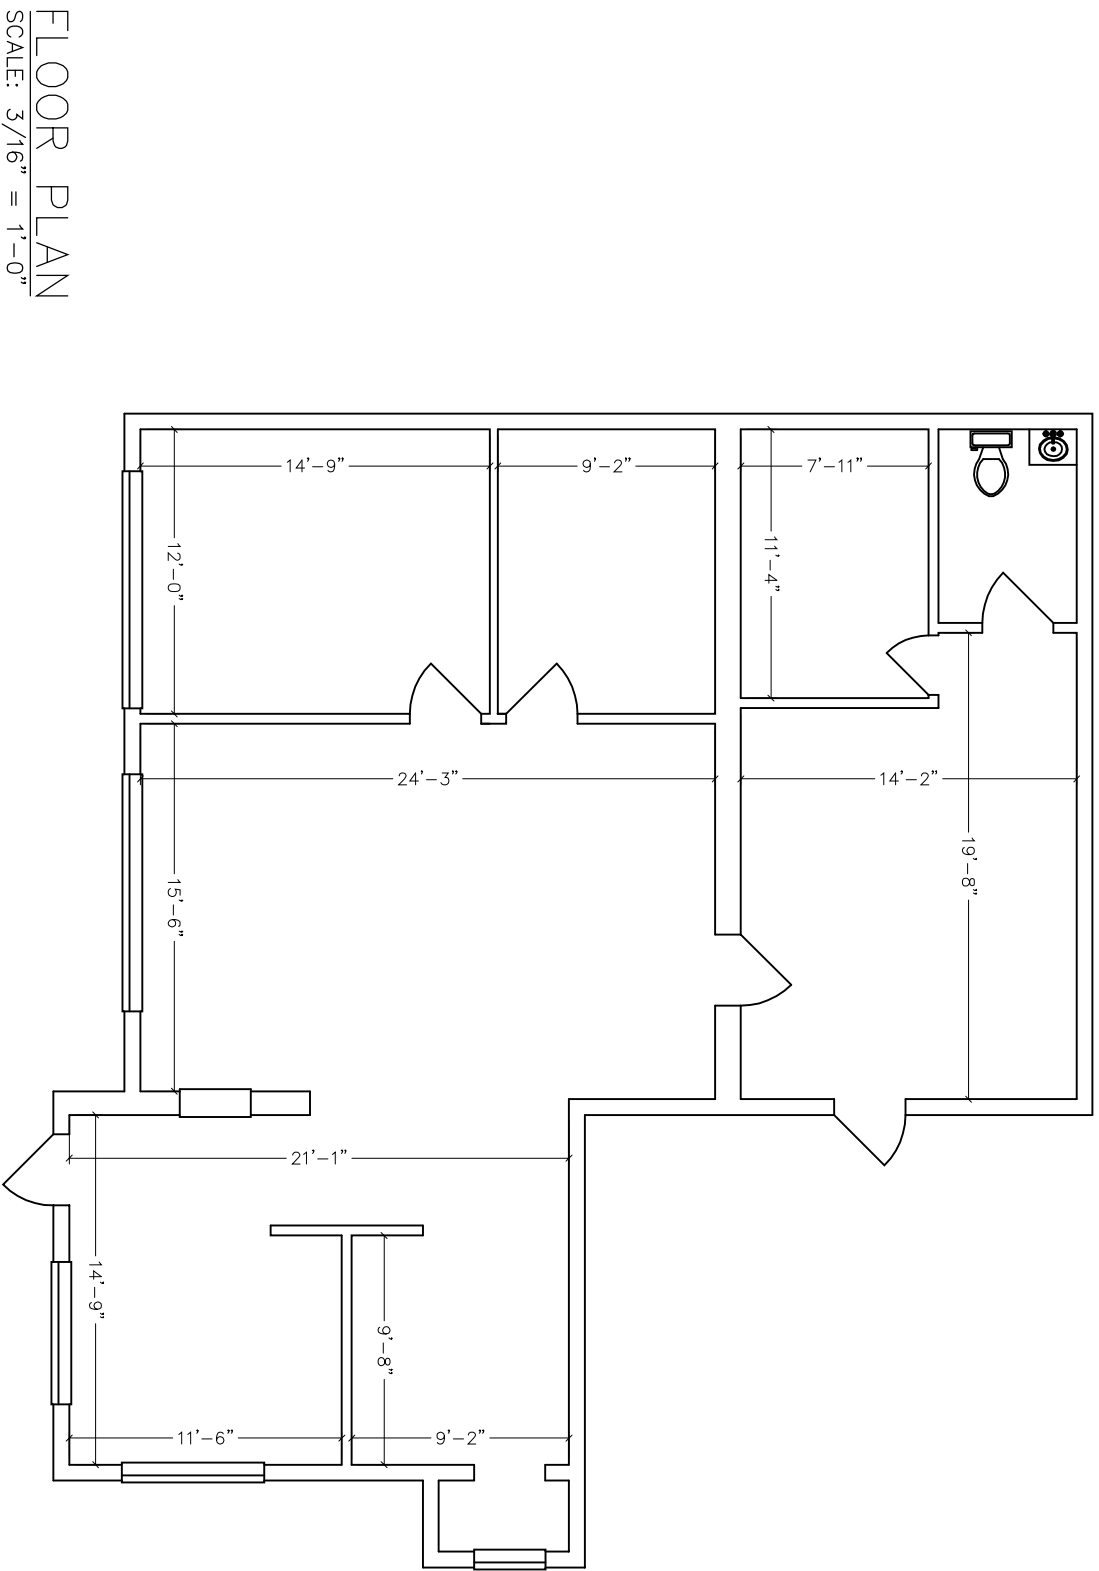

FLOOR PLAN

SCALE: 3/16" = 1'-0"

Wohlford Contracting Inc.

1630 Breaburn Dr.

Suite B

Salem, VA 24153

P (540) 529-8512

Project:

As-Built Floor Plan

30 West Main St.
Salem, VA 24153

Sheet No.

1

Date: 10/7/18

Drawn by: JB